

I/O EXPANDER

PWM GENERATOR

Differential I2C

BOT-HOVEN Hand PCB Version 1
AS-BUILT


Drawn: Jascha Petersen

Sheet: /
File: left_hand.kicad_sch


Title: Hand PCB Main

Size: A4	Date:	Rev:
KiCad E.D.A. 9.0.0		Id: 1/2

LEFT HAND
I2C TRANSCEIVER

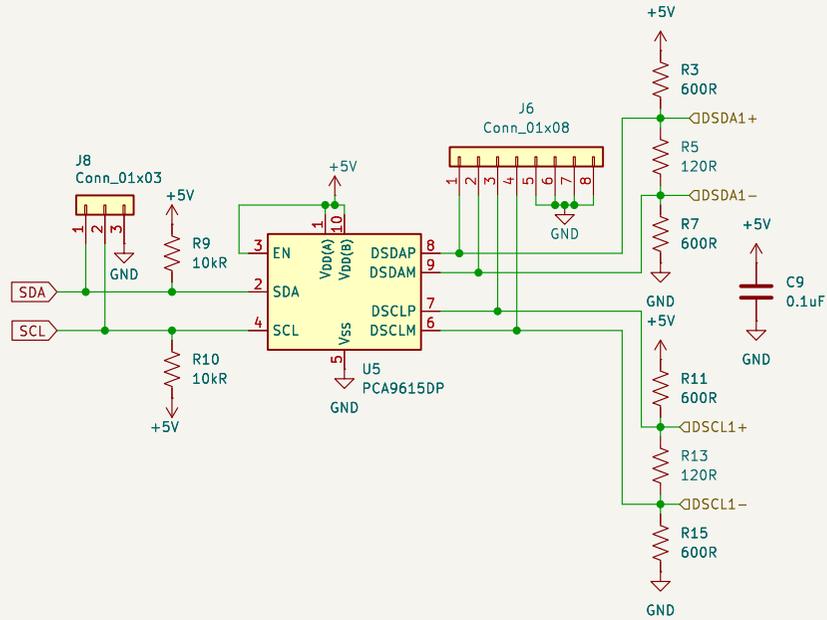

RIGHT HAND
I2C TRANSCEIVER

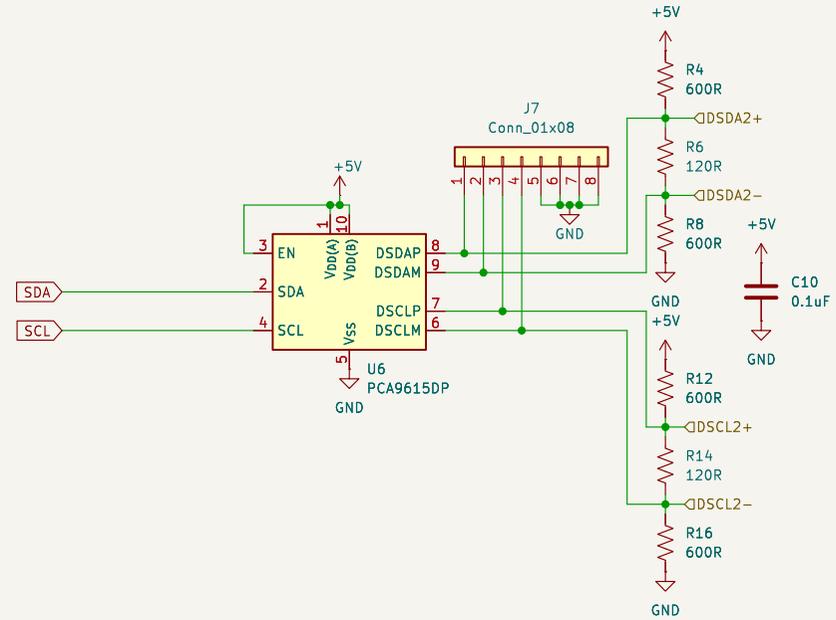

BOT-HOVEN Control PCB Version 1
AS-BUILT

Drawn: Jascha Petersen

Sheet: /Differential I2C/

File: diff_i2c.kicad_sch

Title: Control PCB Differential I2C

Size: A4

Date:

Rev:

KiCad E.D.A. 9.0.0

Id: 2/2